


MICROFLECT PORTS

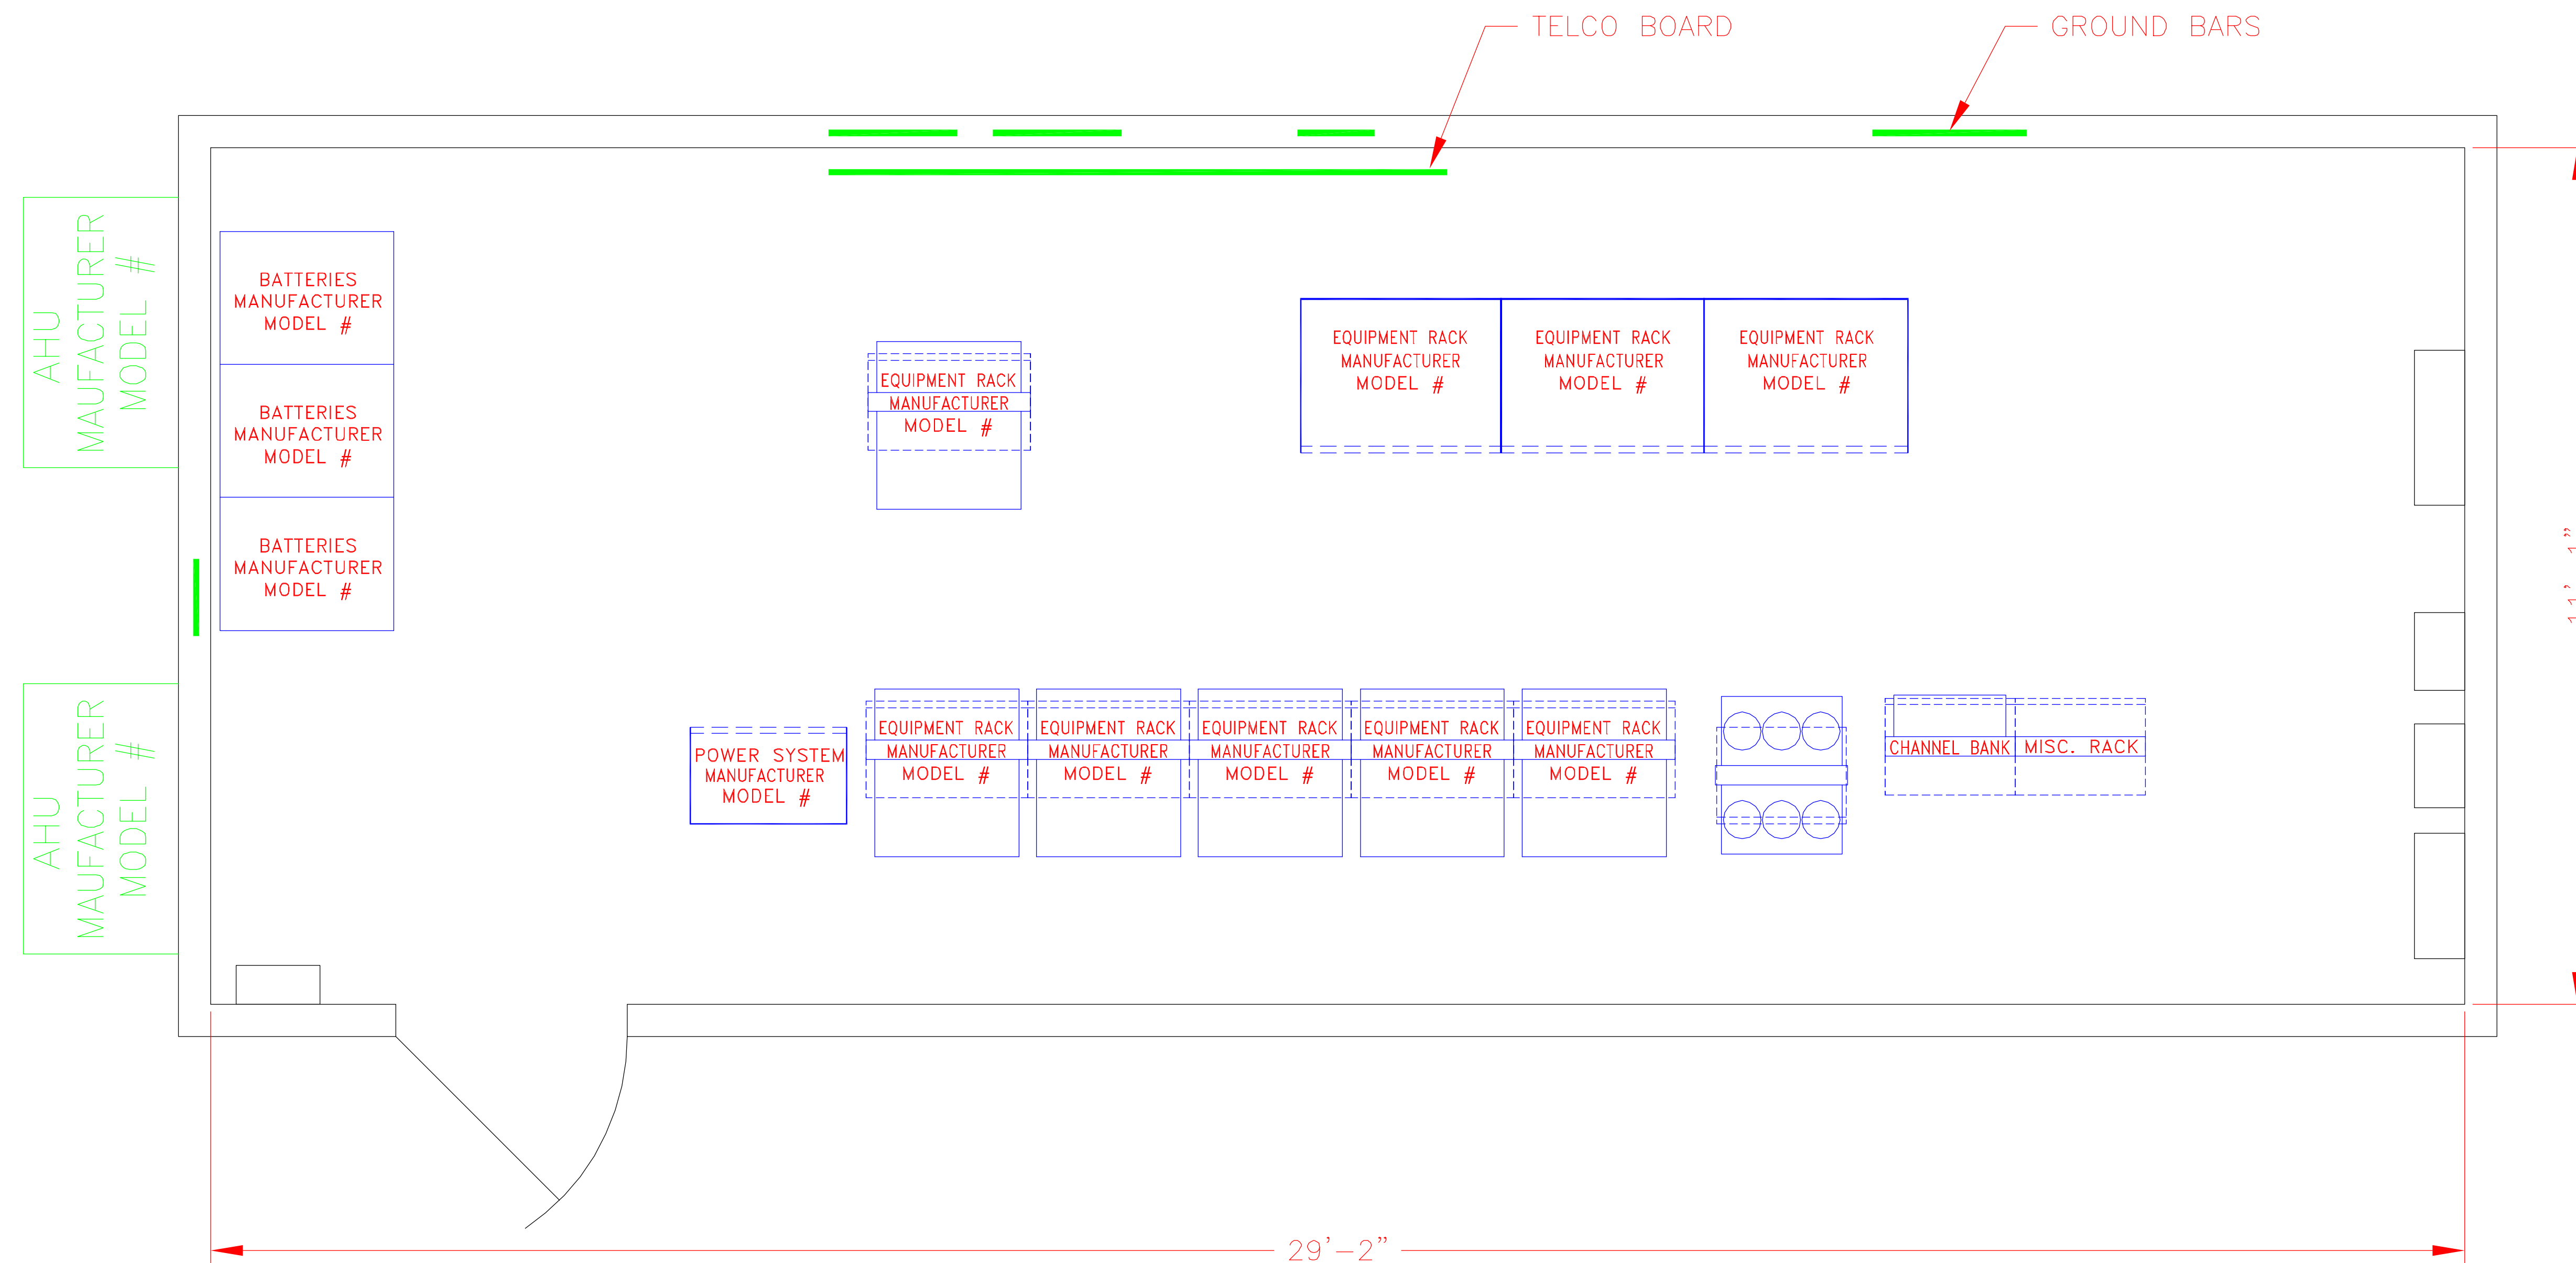

EQUIPMENT AND GROUND BAR LOCATIONS

SCALE: 1/8" = 1'-0"